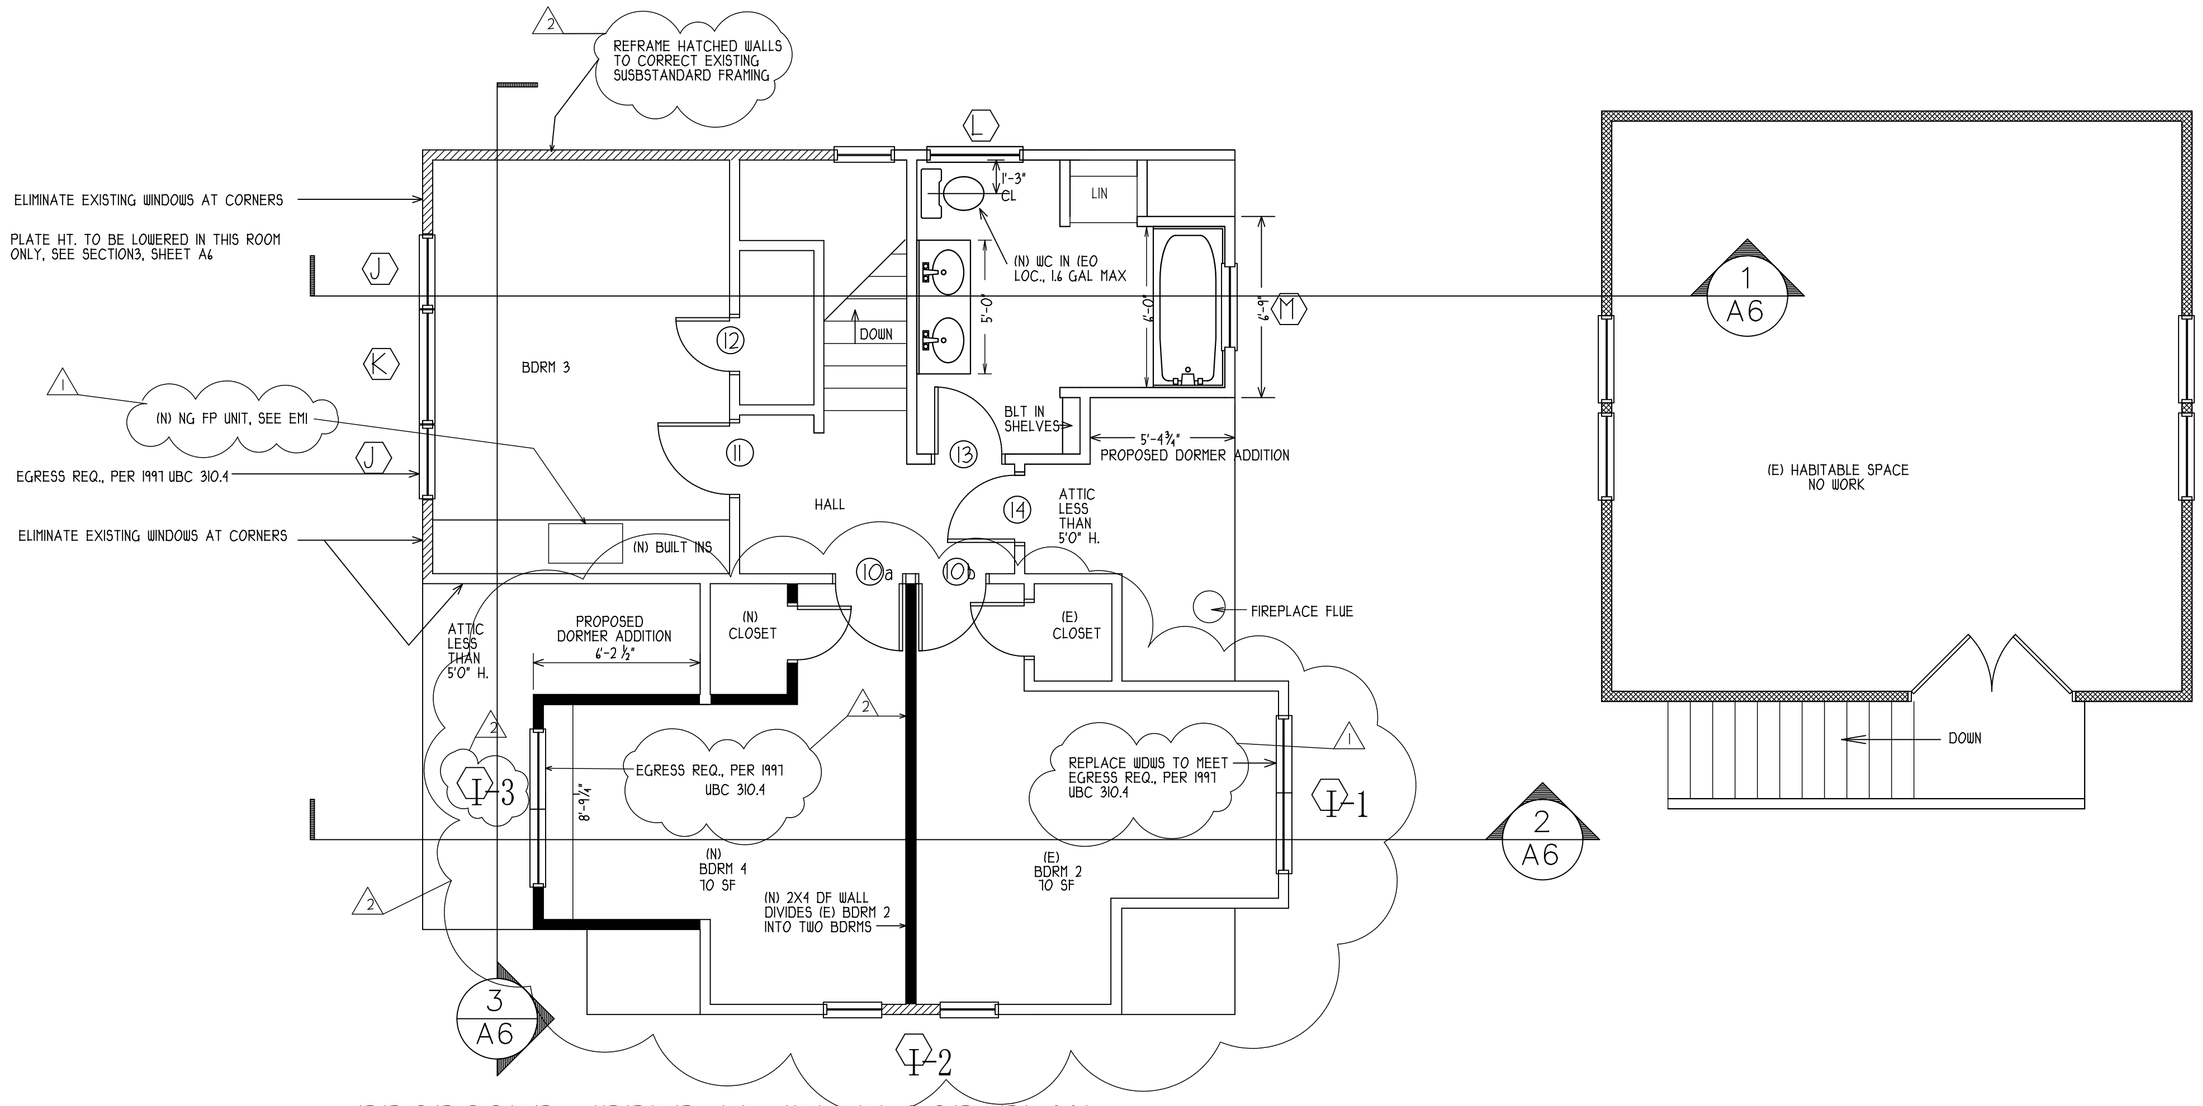

PROPOSED UPPER LEVEL FLOOR PLAN

1/4"=1'-0"

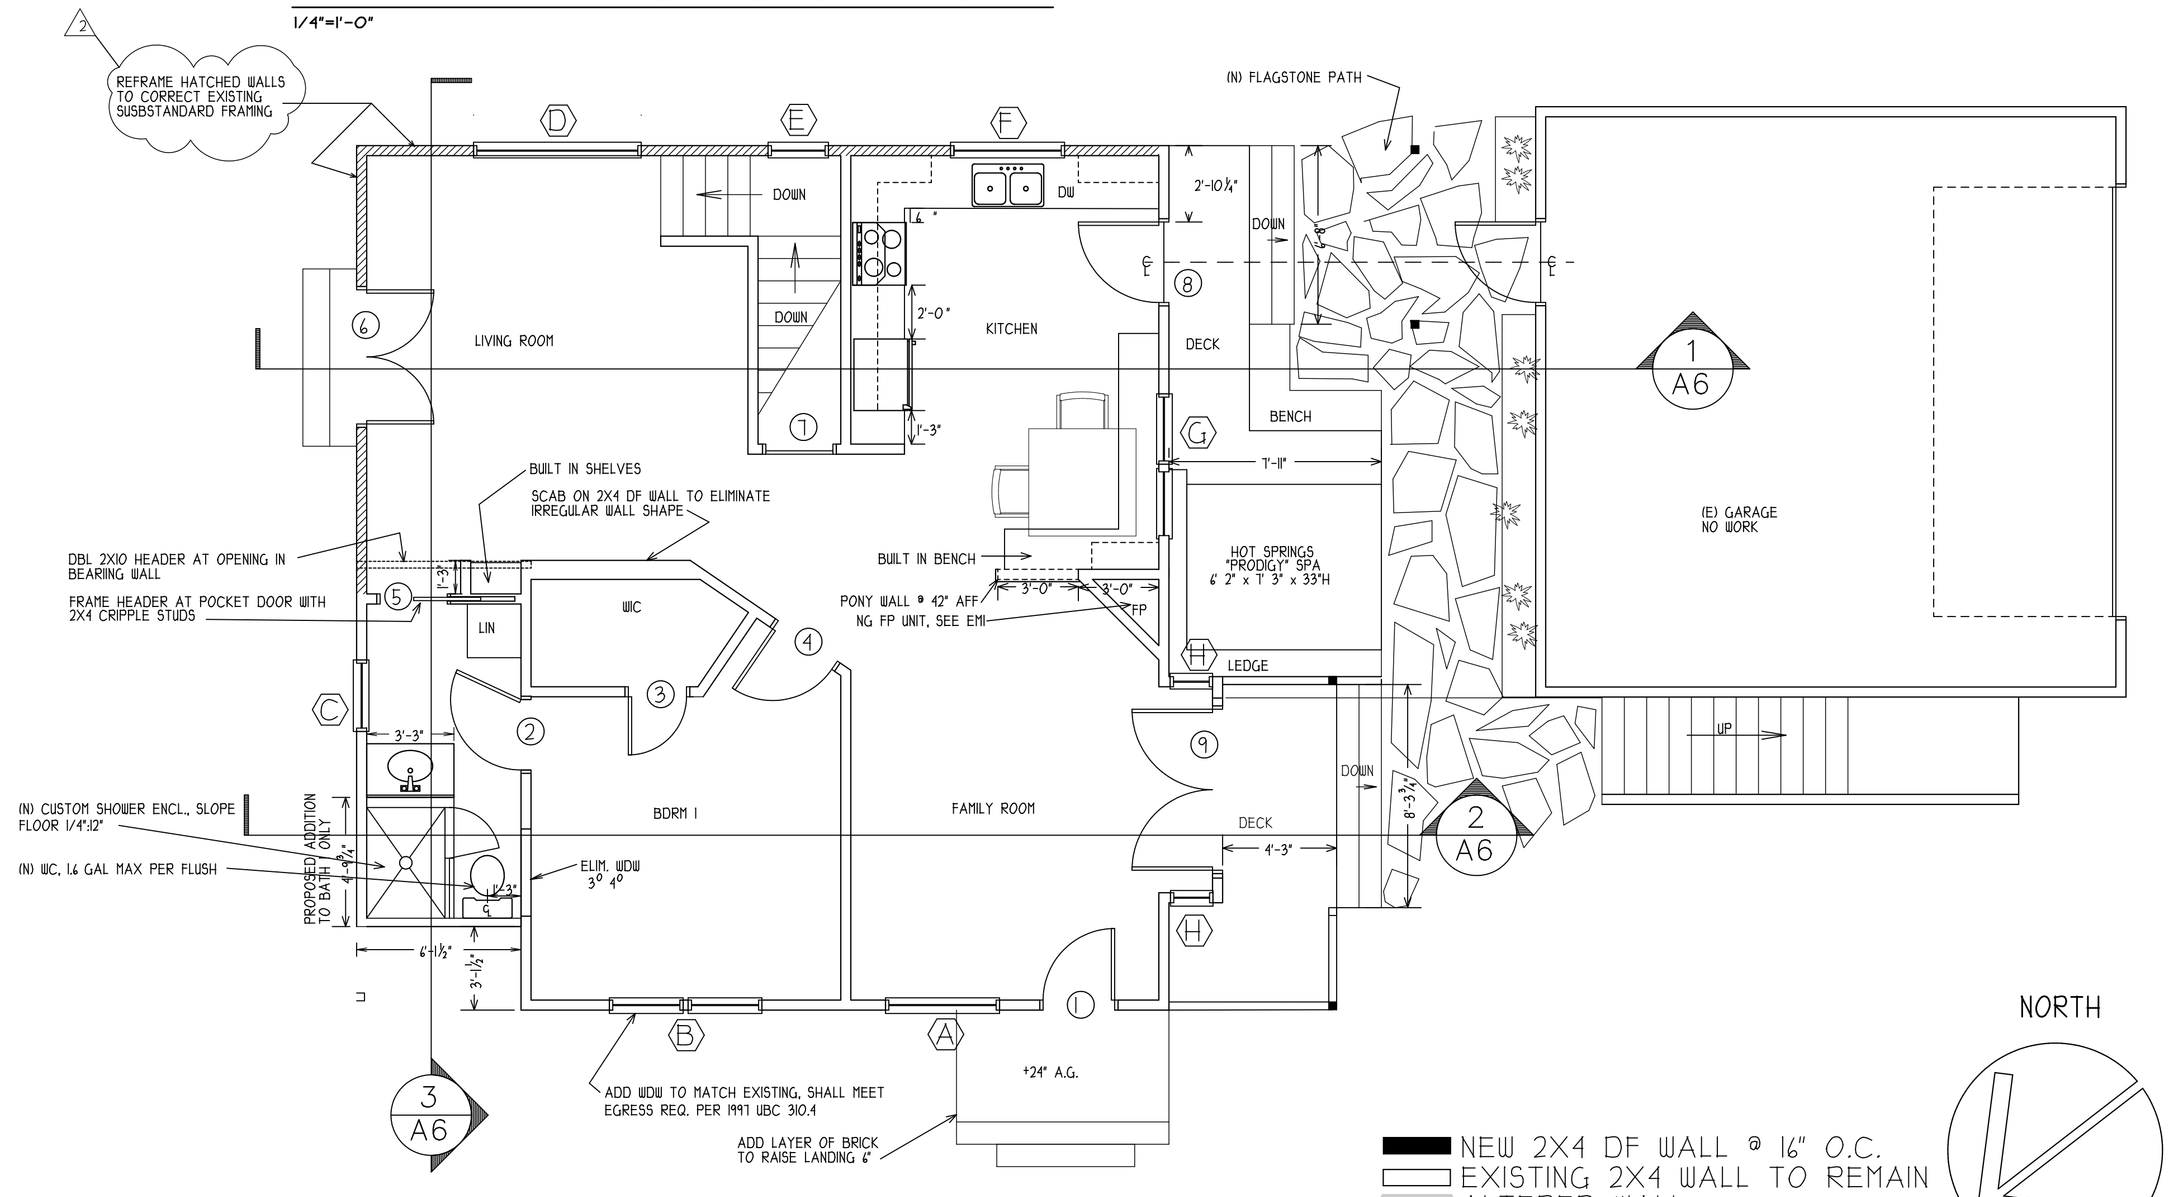

PROPOSED LOWER LEVEL FLOOR PLAN

1/4"=1'-0"

NEW 2X4 DF WALL @ 16" O.C.
EXISTING 2X4 WALL TO REMAIN
ALTERED WALL

NORTH

Jenny Shelton
5408 Baffy Court
Soquel, CA 95073
tel 831.479.3429
www.sheltondesign.com

SHELTON DESIGN
Healthy Home. Healthy Planet.

JENNY SHELTON EXPRESSLY RESERVES THE COMMON LAW COPYRIGHT AND OTHER PROPERTY RIGHTS IN THESE PLANS. THESE PLANS ARE NOT TO BE REPRODUCED, CHANGED, OR COPIED IN ANY FORM OR MANNER WHATSOEVER, NOR ARE THEY TO BE ASSIGNED TO ANY THIRD PARTY WITHOUT FIRST OBTAINING THE EXPRESS WRITTEN PERMISSION AND CONSENT OF JENNY SHELTON.

Glenn & Patricia GRAGG Residence

1320 Harper Street, Santa Cruz, CA 95062

APN 026 611 01

PROPOSED FLOOR PLAN

REVISIONS		
NO.	DATE	REMARK
1	03.14.08	per county plan check 02.14.08
2	07.01.08	change order

DRAWING DATE: 07.01.08

DRAWN BY: J. Shelton

SCALE: 1/4" = 1'-0"

SHEET NO.: A4 OF ELEVEN SHEETS